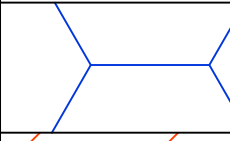
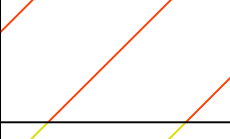
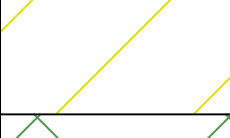


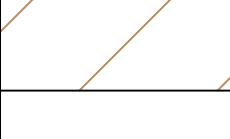


1 SECOND FLOOR PLAN
SCALE: 3/16" = 1'-0"

AREA SUMMARY		
	PUBLIC SPACE	2,177 SF
	SPACE 1	3,958 SF
	SPACE 2	407 SF
	SPACE 3	2,940 SF
	SPACE 4	568 SF
	SPACE 5	4,229 SF
	TOTAL BUILDING	14,279 SF

SHEET: **A-2** OF TWO DATE: 10-29-2015
 JTR - LAYOUT 10-26-15 CLIENT: 4500 Carter Creek Bryan, Texas
 JTR - LAYOUT 10-29-15
 PROJECT SITE INFO: 4500 Carter Creek Bryan, Texas
 JOB# 15-087
R.A.I. DESIGNS, INC.
 (979) 846-3366
 4500 Carter Creek Dr. #203 Bryan, TX 77802 www.raidesigns.com
 © COPYRIGHT 2015 BY R.A.I.